



PLATFORM CAMPUS FLOOR PLANS

AS-BUILT



DIRECT ACCESS & VIEW OF LEGACY PARK



EXCLUSIVE PATIO SPACE




MODERN DESIGN



ROLL UP DOOR



INTIMATE CAMPUS SETTING

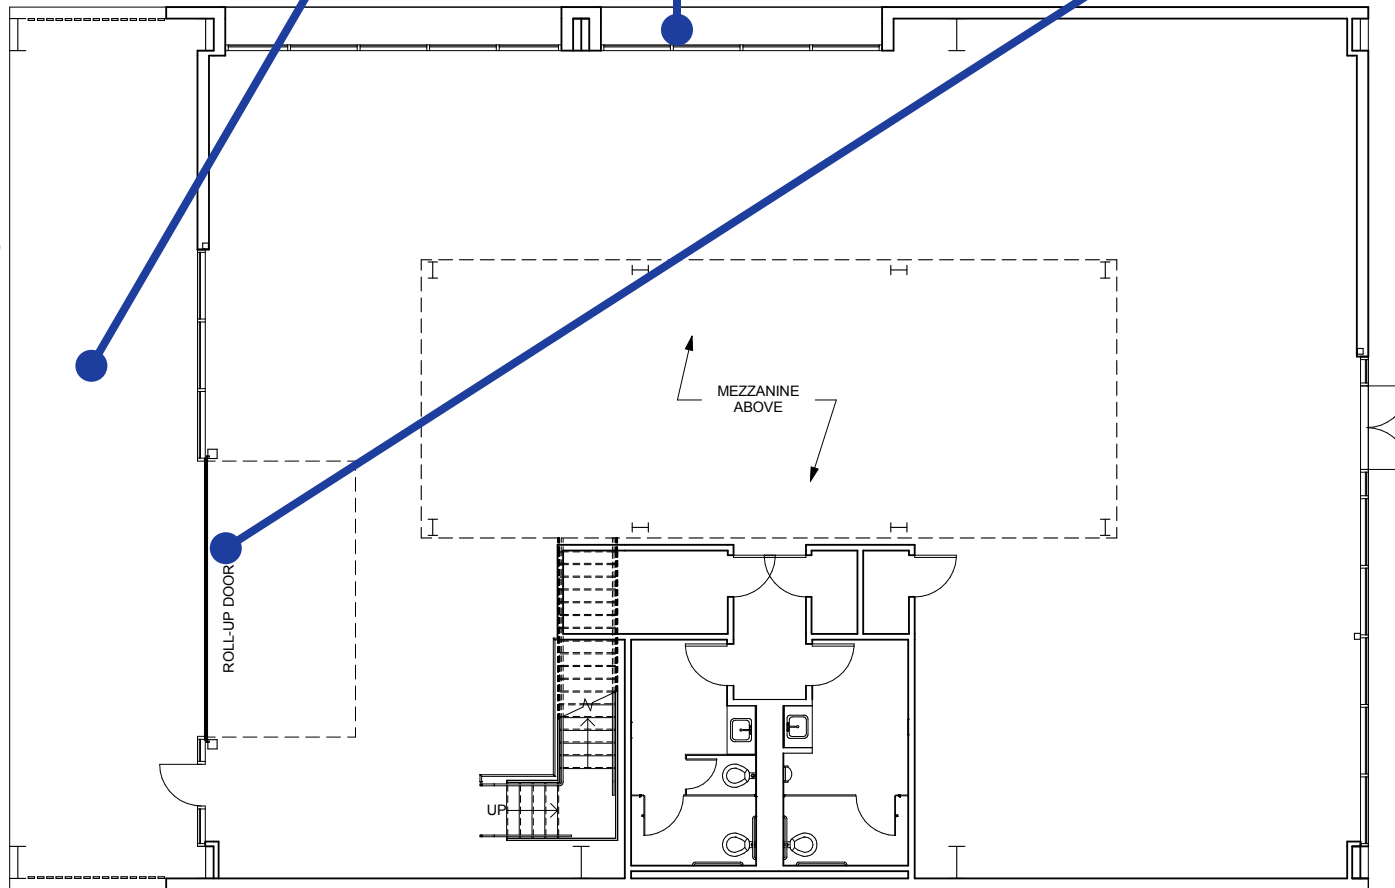

BUILDING E 6,904 RSF



AS-BUILT



DIRECT ACCESS & VIEW OF LEGACY PARK



EXCLUSIVE PATIO SPACE




MODERN DESIGN



ROLL UP DOOR



INTIMATE CAMPUS SETTING

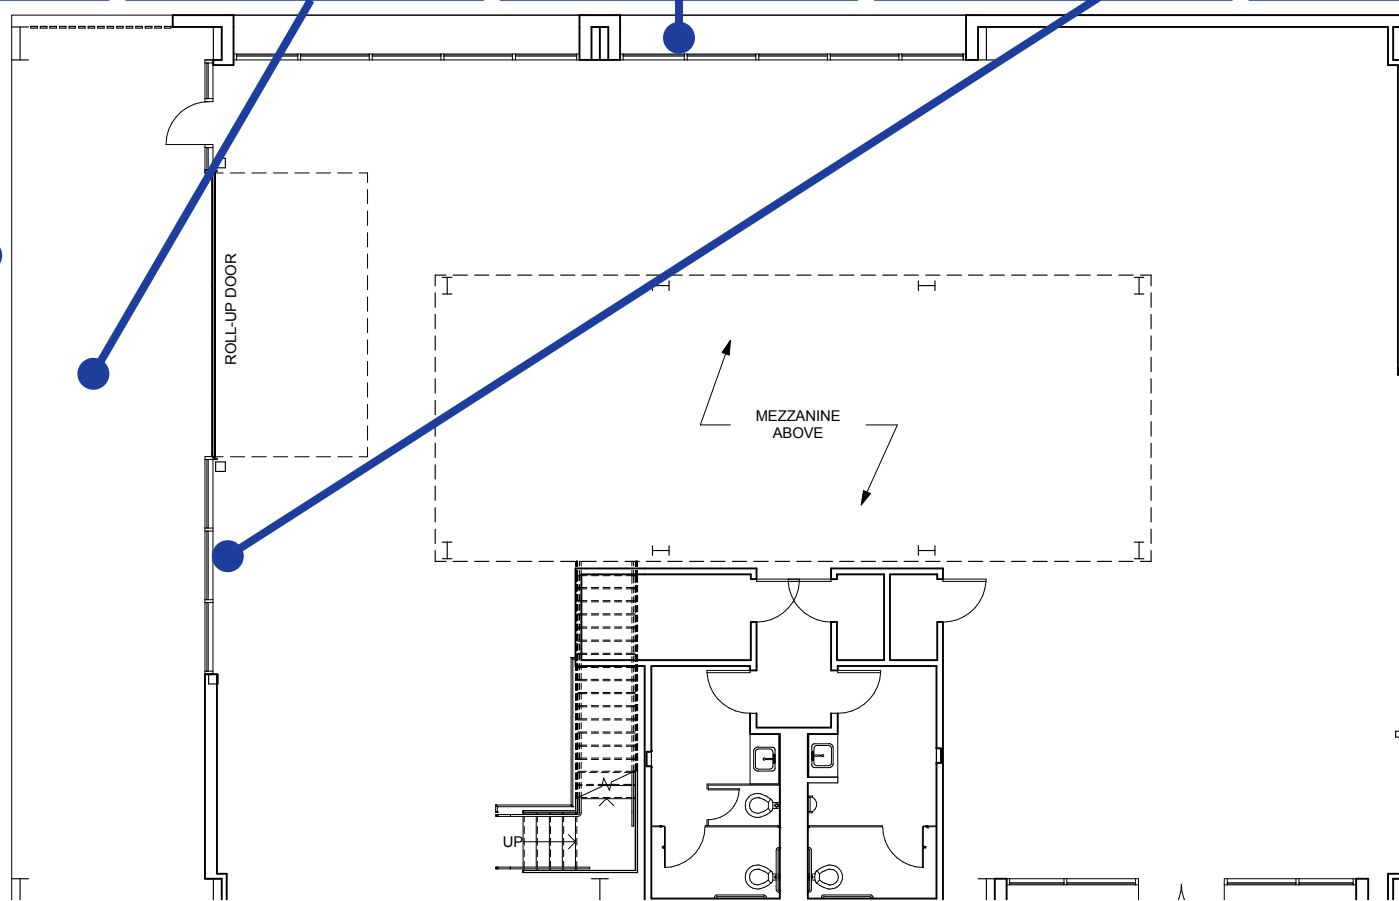

BUILDING F
6,824 RSF



AS-BUILT



DIRECT ACCESS & VIEW OF LEGACY PARK




EXCLUSIVE PATIO SPACE



MODERN DESIGN



INTIMATE CAMPUS SETTING

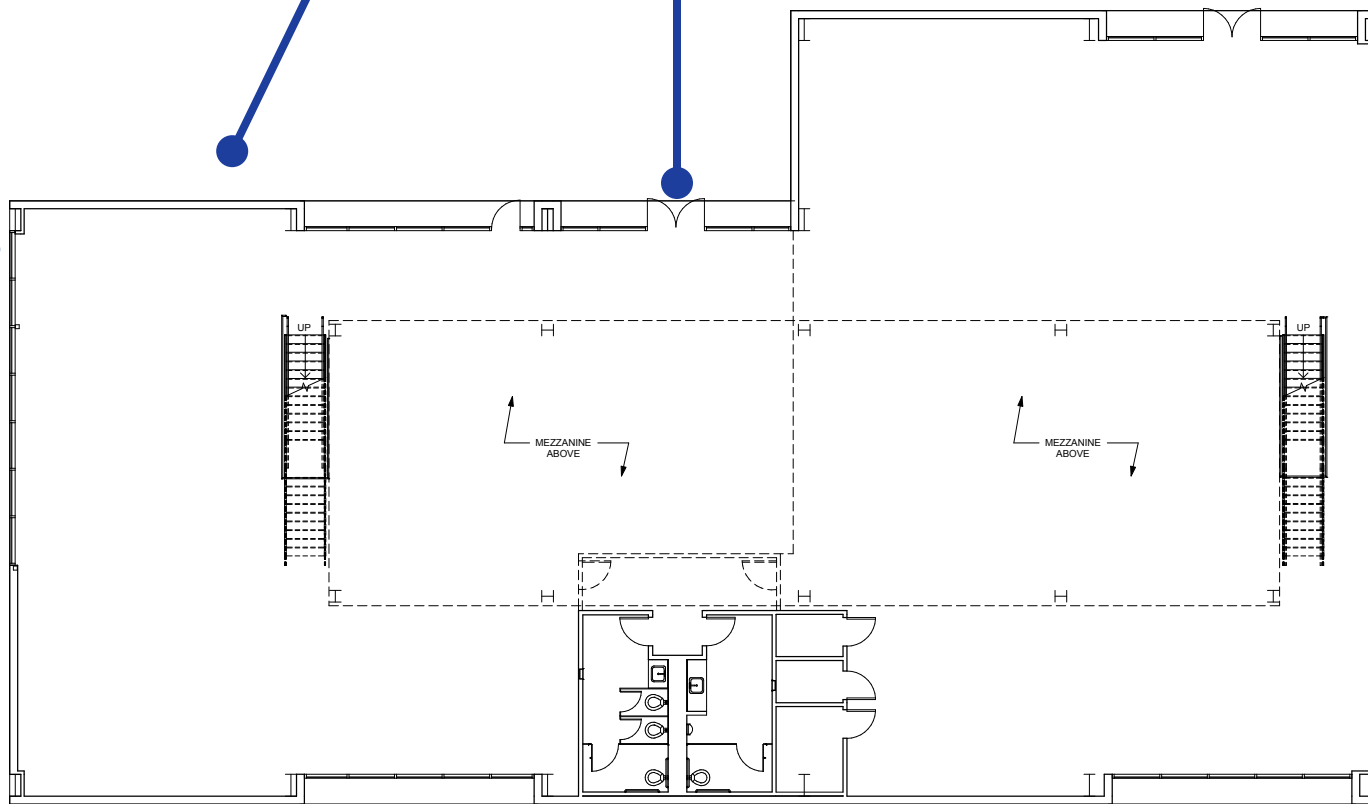

BUILDING G 12,889 RSF



AS-BUILT




DIRECT ACCESS & VIEW OF LEGACY PARK



MEZZANINE SPACE




MODERN DESIGN

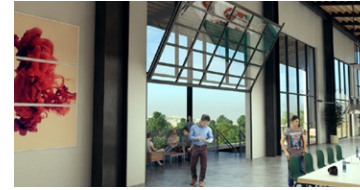

ROLL UP DOOR



INTIMATE CAMPUS SETTING

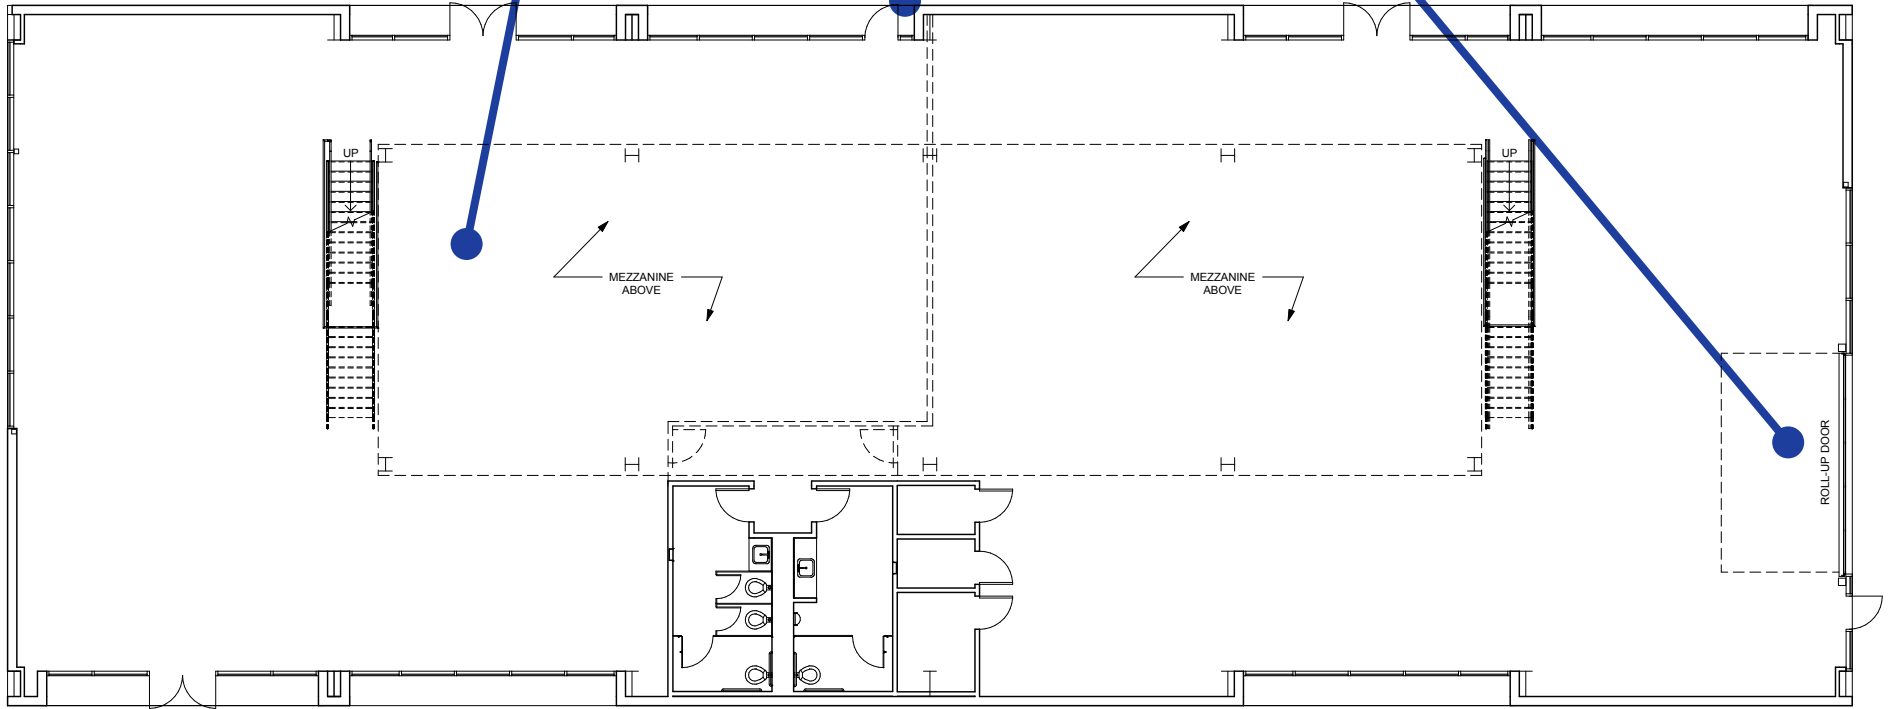

BUILDING H 12,991 RSF

